


As-Built Survey

Sendera Lakes Section 2


Moore, Cleveland County, Oklahoma

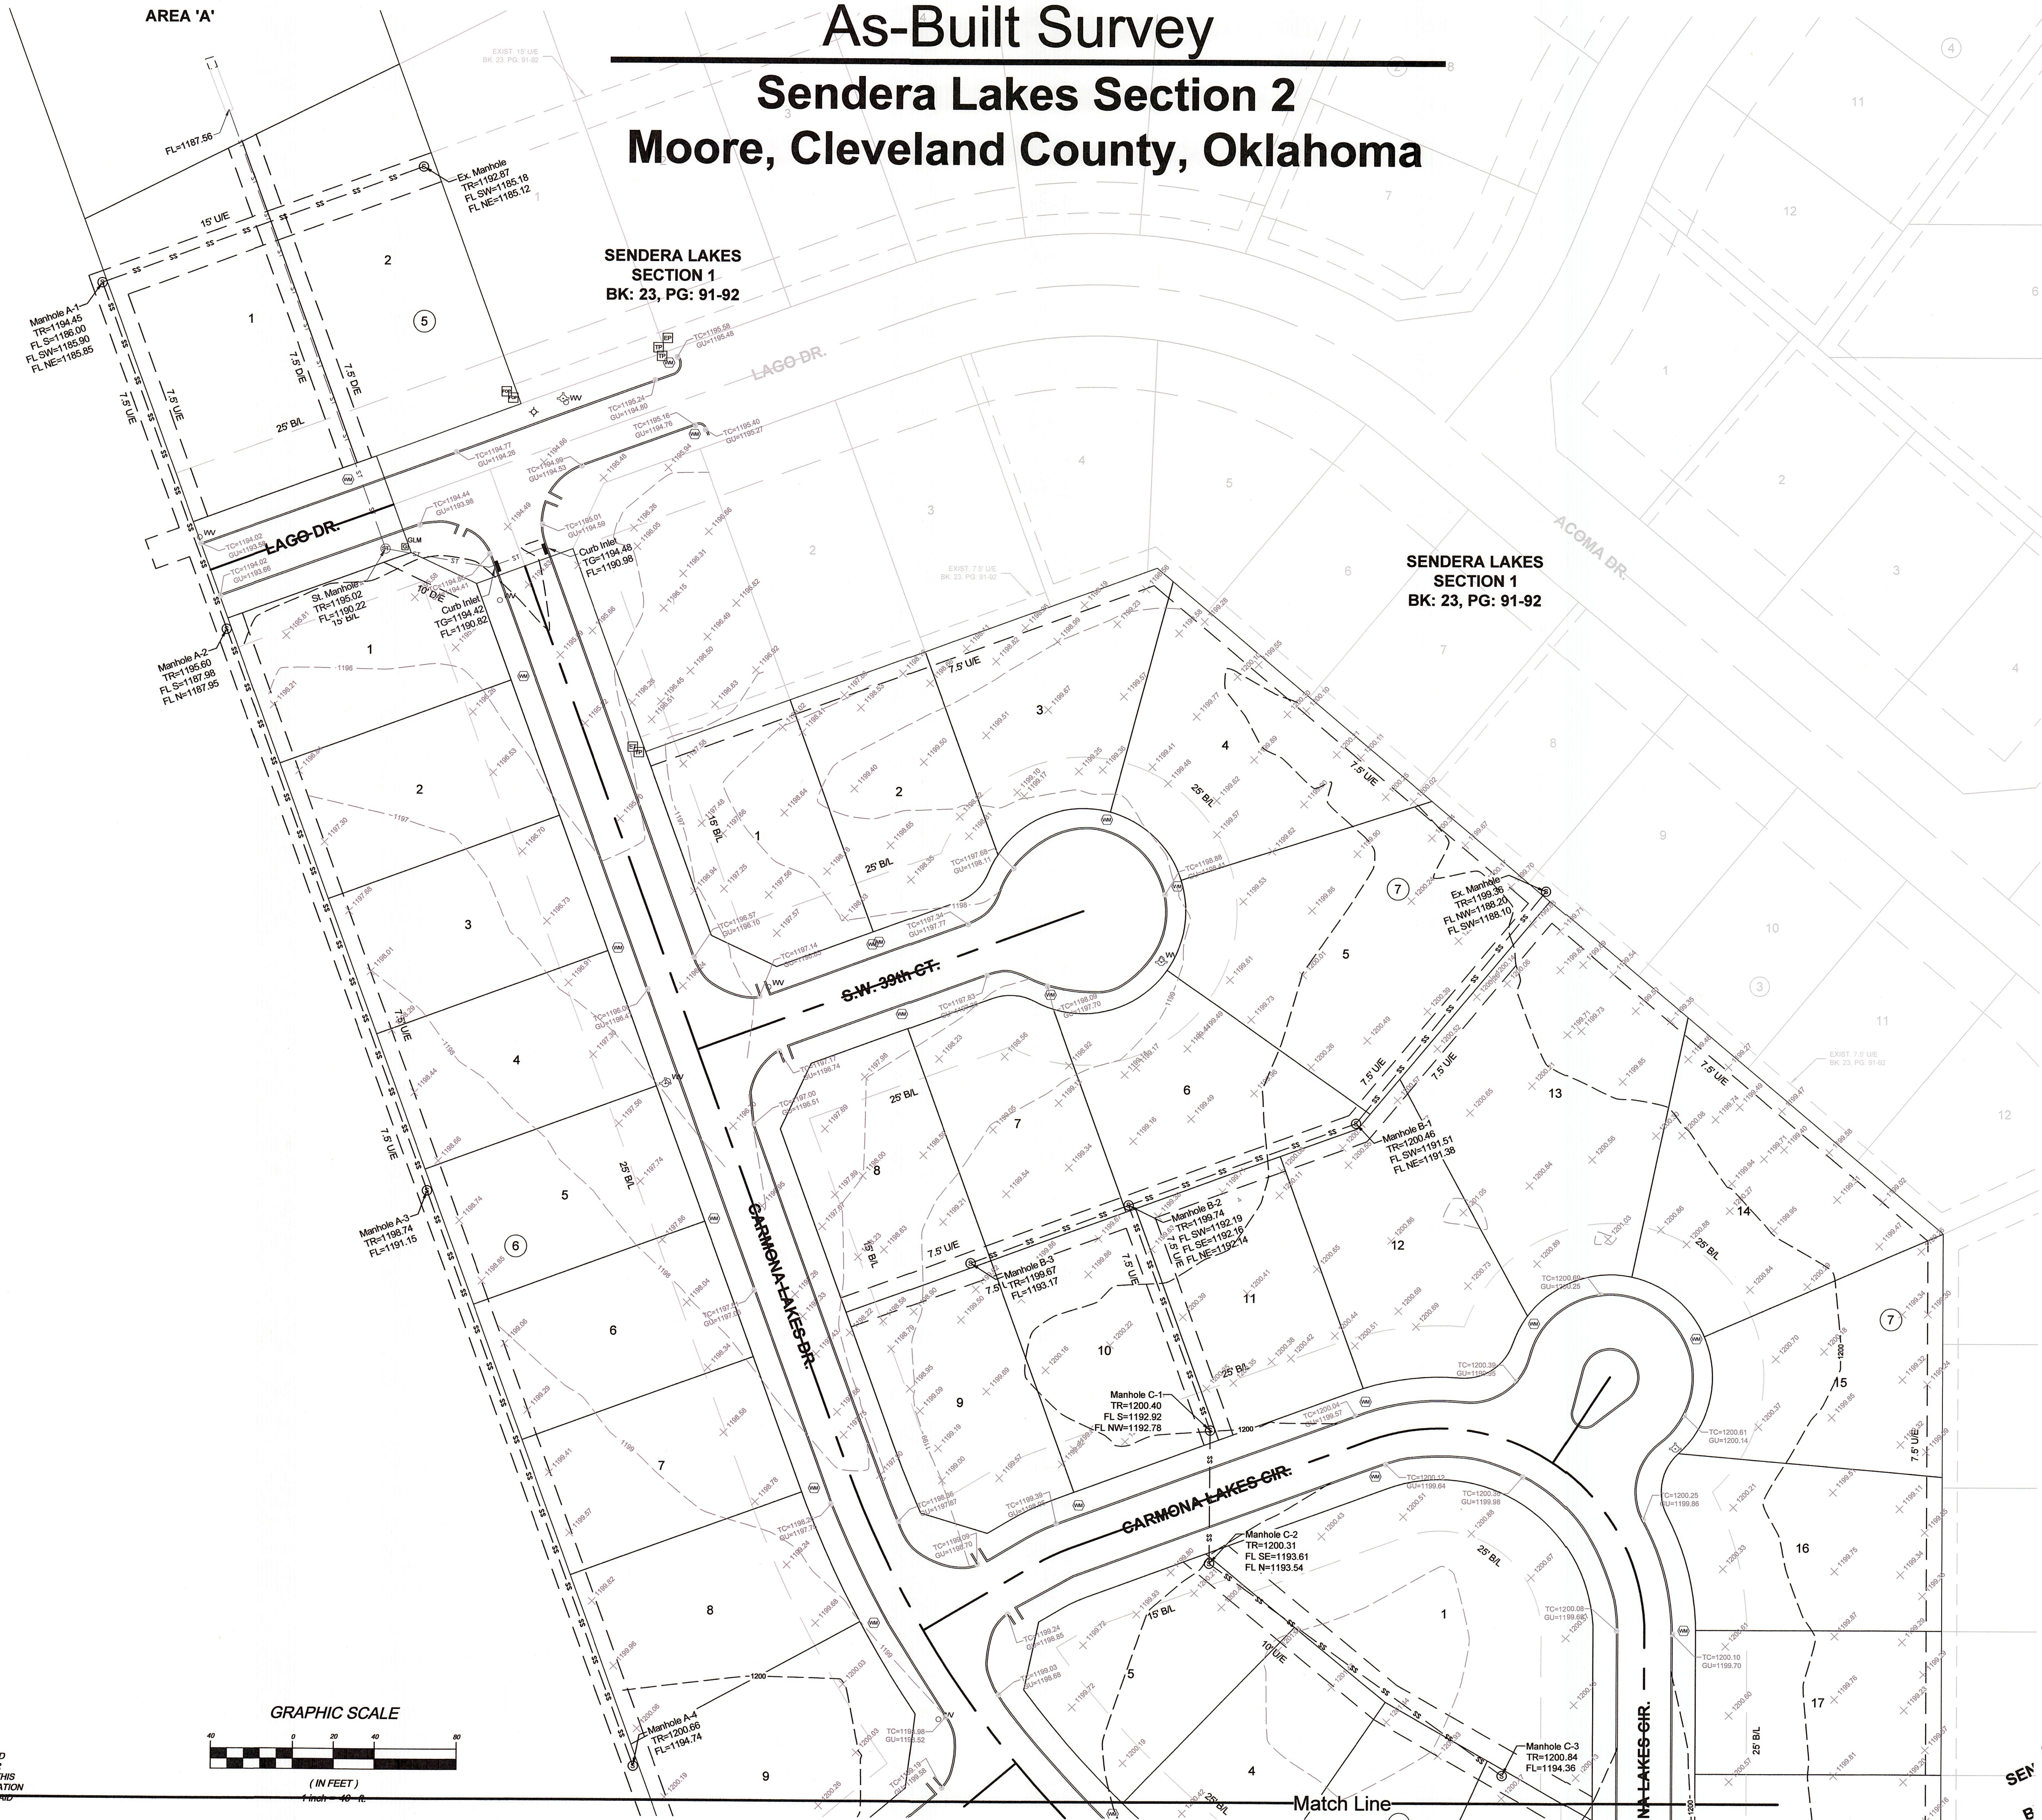

BEFORE YOU DIG...
CALL OKIE

OKLAHOMA
ONE-CALL
SYSTEM, INC.
800-522-OKIE (6543)
TULSA (918) 732-OKIE (6543)
OKC (405) 840-5032

THE UTILITIES AS SHOWN ON THIS DRAWING WERE DEVELOPED FROM THE INFORMATION AVAILABLE. THIS IS NOT IMPLIED NOR INTENDED TO BE THE COMPLETE INVENTORY OF UTILITIES IN THIS AREA. IT IS THE CLIENT'S RESPONSIBILITY TO VERIFY THE LOCATION OF ALL UTILITIES (WHETHER SHOWN OR NOT) AND PROTECT SUCH UTILITIES FROM ANY DAMAGE.

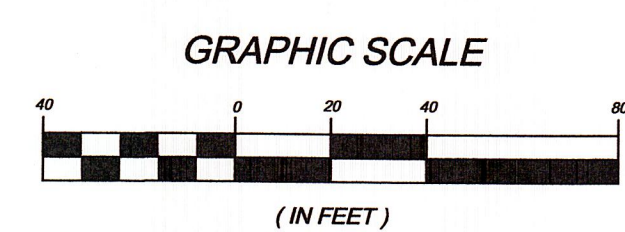

SEV
B

6-28-16

CURTIS LEE
HALE
L.S. 1084
OKLAHOMA

PROJECT NAME	
Sendera Lakes Section 2 Moore, Oklahoma As-Built Survey	

PROJECT NO.	
5374.4	

DATE	
6/7/2016	

DRAWN BY	
JMS	

CHECKED BY	
CLH	

FIELD CREW	
CH, JB	

SHEET	
1 OF 2	

CLIENT	
David Odum 2300 SW 89th Street, Suite A Oklahoma City, Oklahoma 73159 (405) 794-6366	

REVISION/ISSUE	
NO.	DATE


Land Surveying and Planning
1601 SW 89th Street, Building C, Suite 200
Oklahoma City, Oklahoma 73159
Tel: (405) 686-0774 - Fax: (405) 681-4881
C.A. - Exp: June 30, 2017
www.haleandcompany.com

Hale & Company
Survey

As-Built Survey

Sendera Lakes Section 2

Moore, Cleveland County, Oklahoma

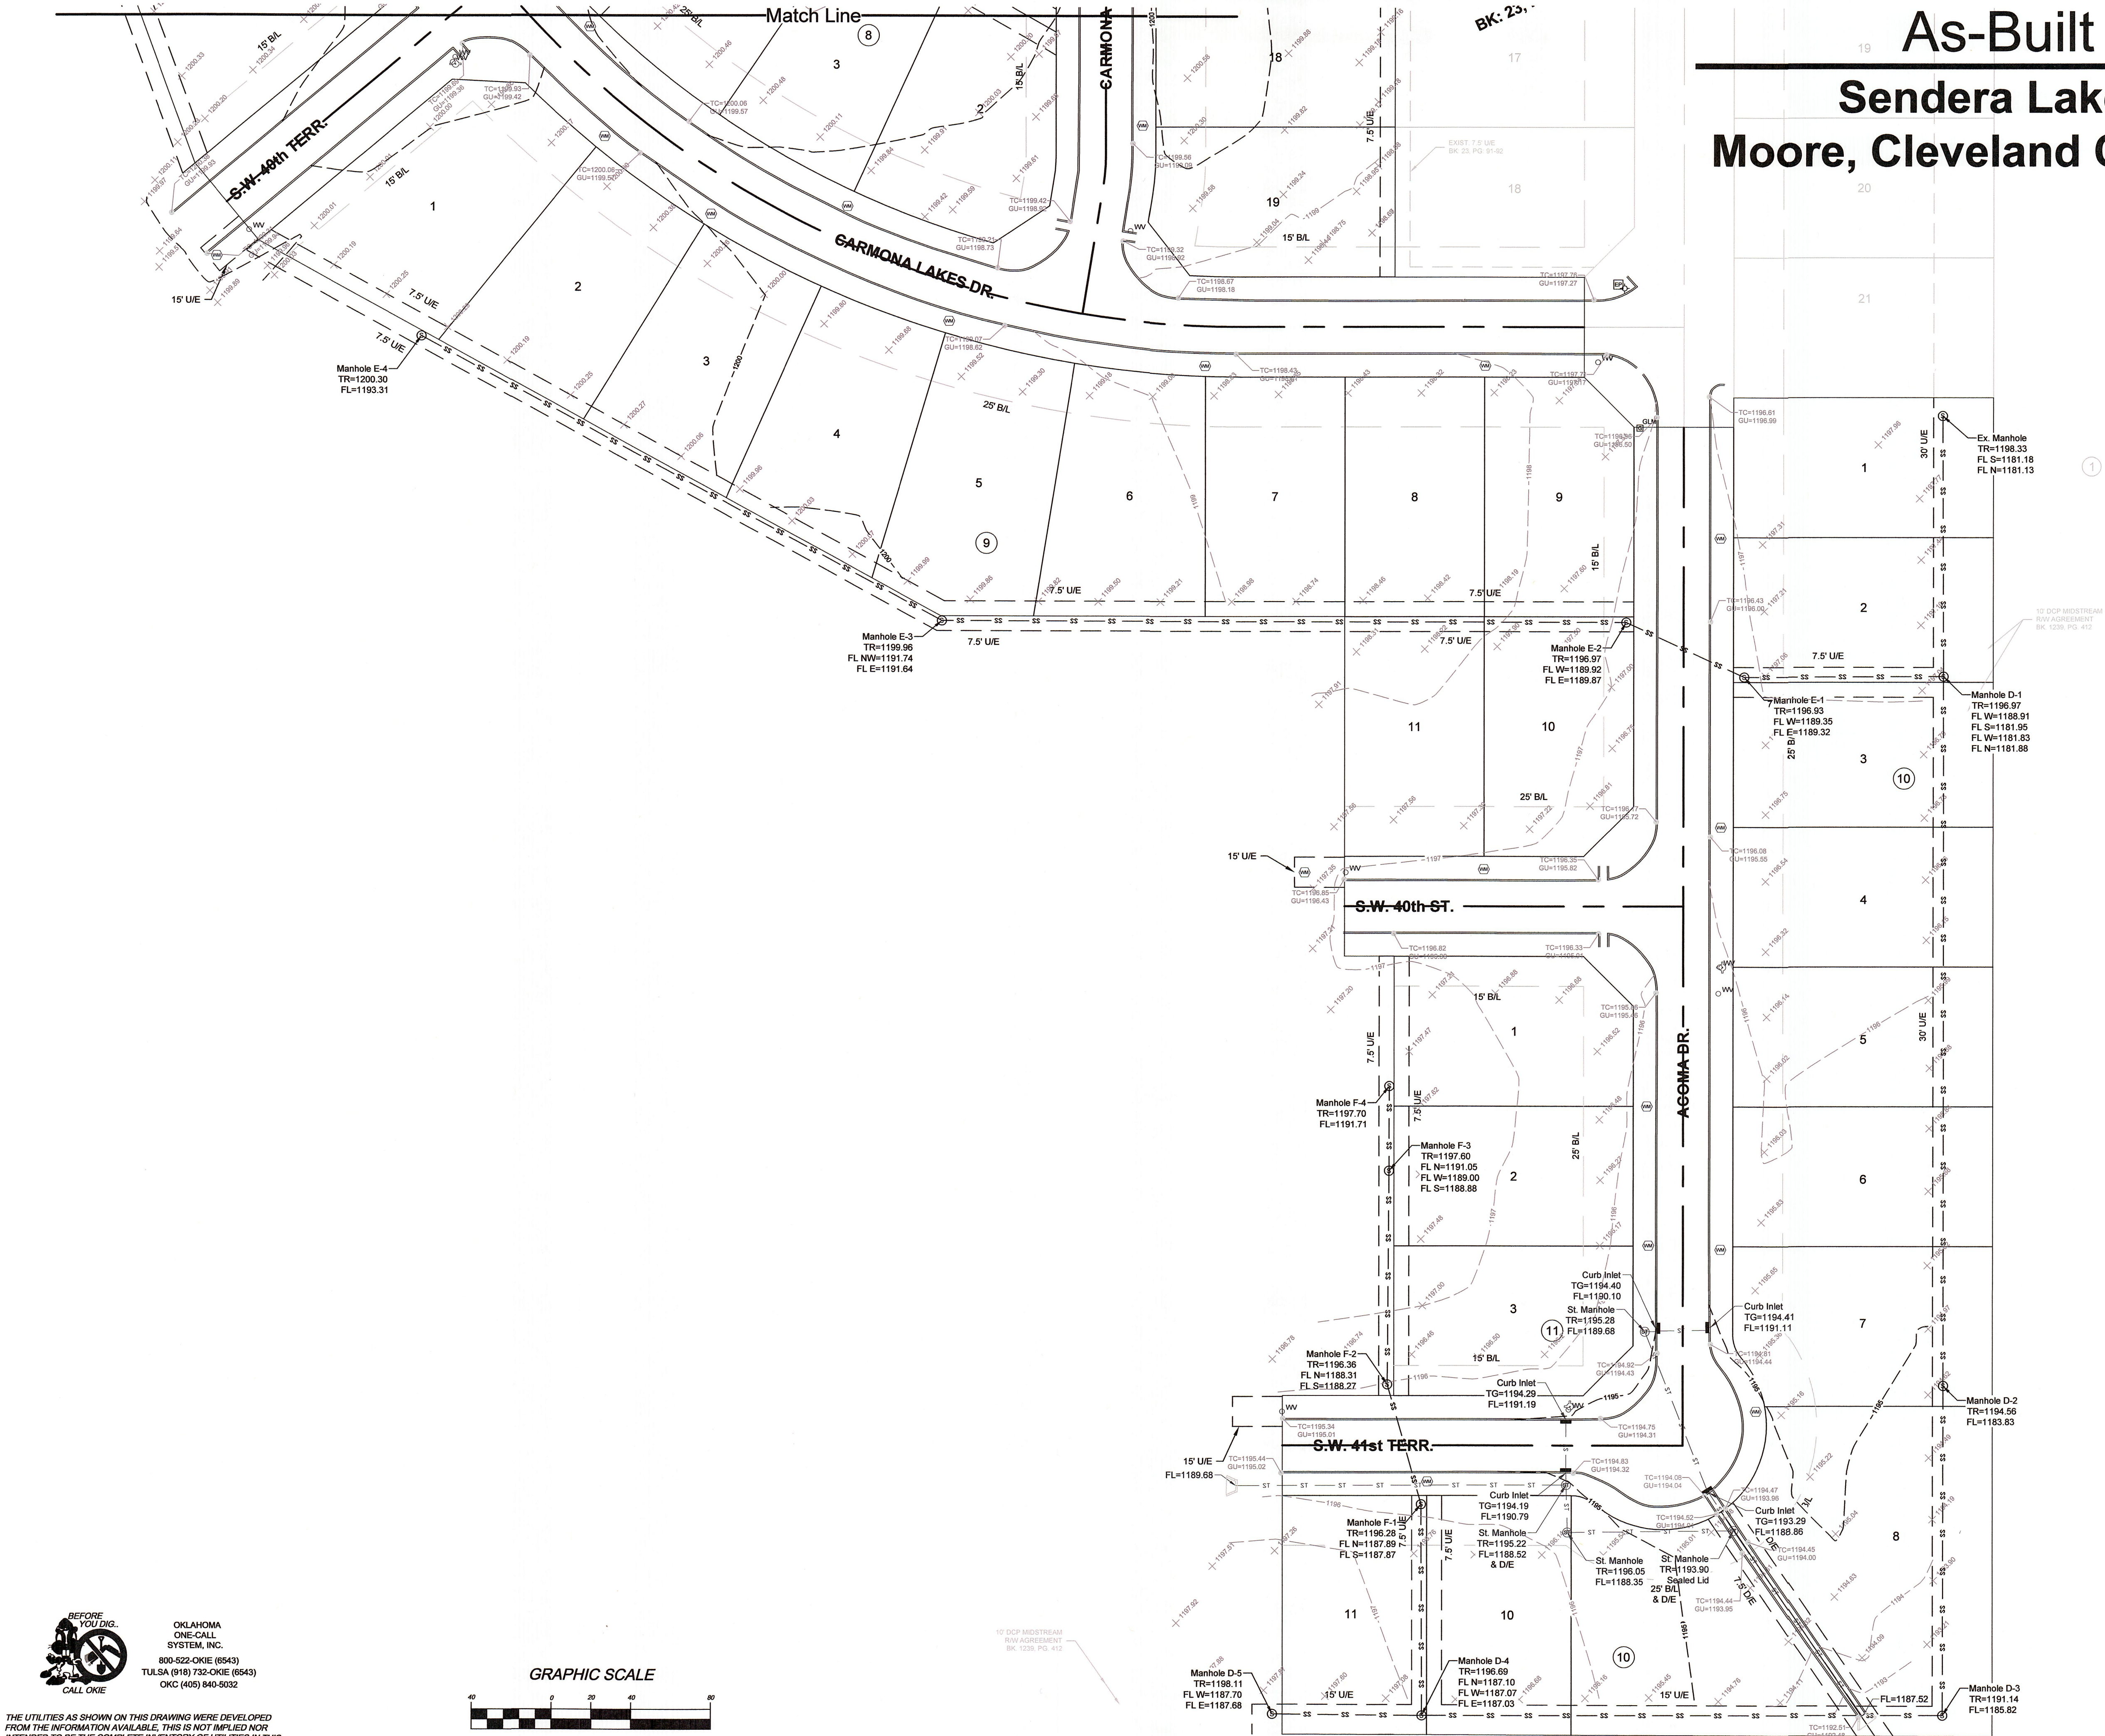

NO.	REVISION/ISSUE	DATE

CLIENT
David Odom
2300 SW 89th Street, Suite A
Oklahoma City, Oklahoma 73159
(405) 794-6366

Land Surveying and Planning
1601 SW 89th Street, Building C, Suite 200
Oklahoma City, Oklahoma 73159
Tel.: (405) 686-0174 Fax: (405) 681-4881
C.A. - 819 - Exp. June 30, 2017
www.halesurvey.com

Assoc. **Hale & Kuehn Survey**

PROJECT NAME
Sendera Lakes Section 2
Moore, Oklahoma
As-Built Survey

PROJECT NO. 5374.4
5374-4 As-Built.dwg
DATE 6/7/2016
DRAWN BY JMS
CHECKED BY CLH
FIELD CREW CH, JB

SHEET
2
OF 2

As-Built Survey

Sendera Lakes Section 2

Moore, Cleveland County, Oklahoma



OKLAHOMA
ONE-CALL
SYSTEM, INC.
800-522-OKIE (6543)
TULSA (918) 732-OKIE (6543)
OKC (405) 840-5032

THE UTILITIES AS SHOWN ON THIS DRAWING WERE DEVELOPED FROM THE INFORMATION AVAILABLE. THIS IS NOT IMPLIED NOR INTENDED TO BE THE COMPLETE INVENTORY OF UTILITIES IN THIS AREA. IT IS THE CLIENT'S RESPONSIBILITY TO VERIFY THE LOCATION OF ALL UTILITIES (WHETHER SHOWN OR NOT) AND PROTECT SAME UTILITIES FROM ANY DAMAGE.

NO.	REVISION/ISSUE	DATE

CLIENT
David Odom
2300 SW 89th Street, Suite A
Oklahoma City, Oklahoma 73159
(405) 794-6366



Land Surveying and Planning
1601 SW 89th Street, Building C, Suite 200
Oklahoma City, Oklahoma 73159
Tel: (405) 686-0774 - Fax: (405) 681-4881
C.A.: 819 - Exp: June 30, 2017
www.lakesurvey.com




PROJECT NAME
Sendera Lakes Section 2
Moore, Oklahoma
As-Built Survey

PROJECT NO.	5374.4
FILE	5374-4 As-Built.dwg
DATE	6/7/2016
DRAWN BY	JMS
CHECKED BY	CLH
FIELD CREW	CH, JB

SHEET
1
OF 2

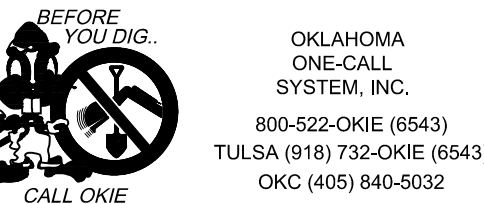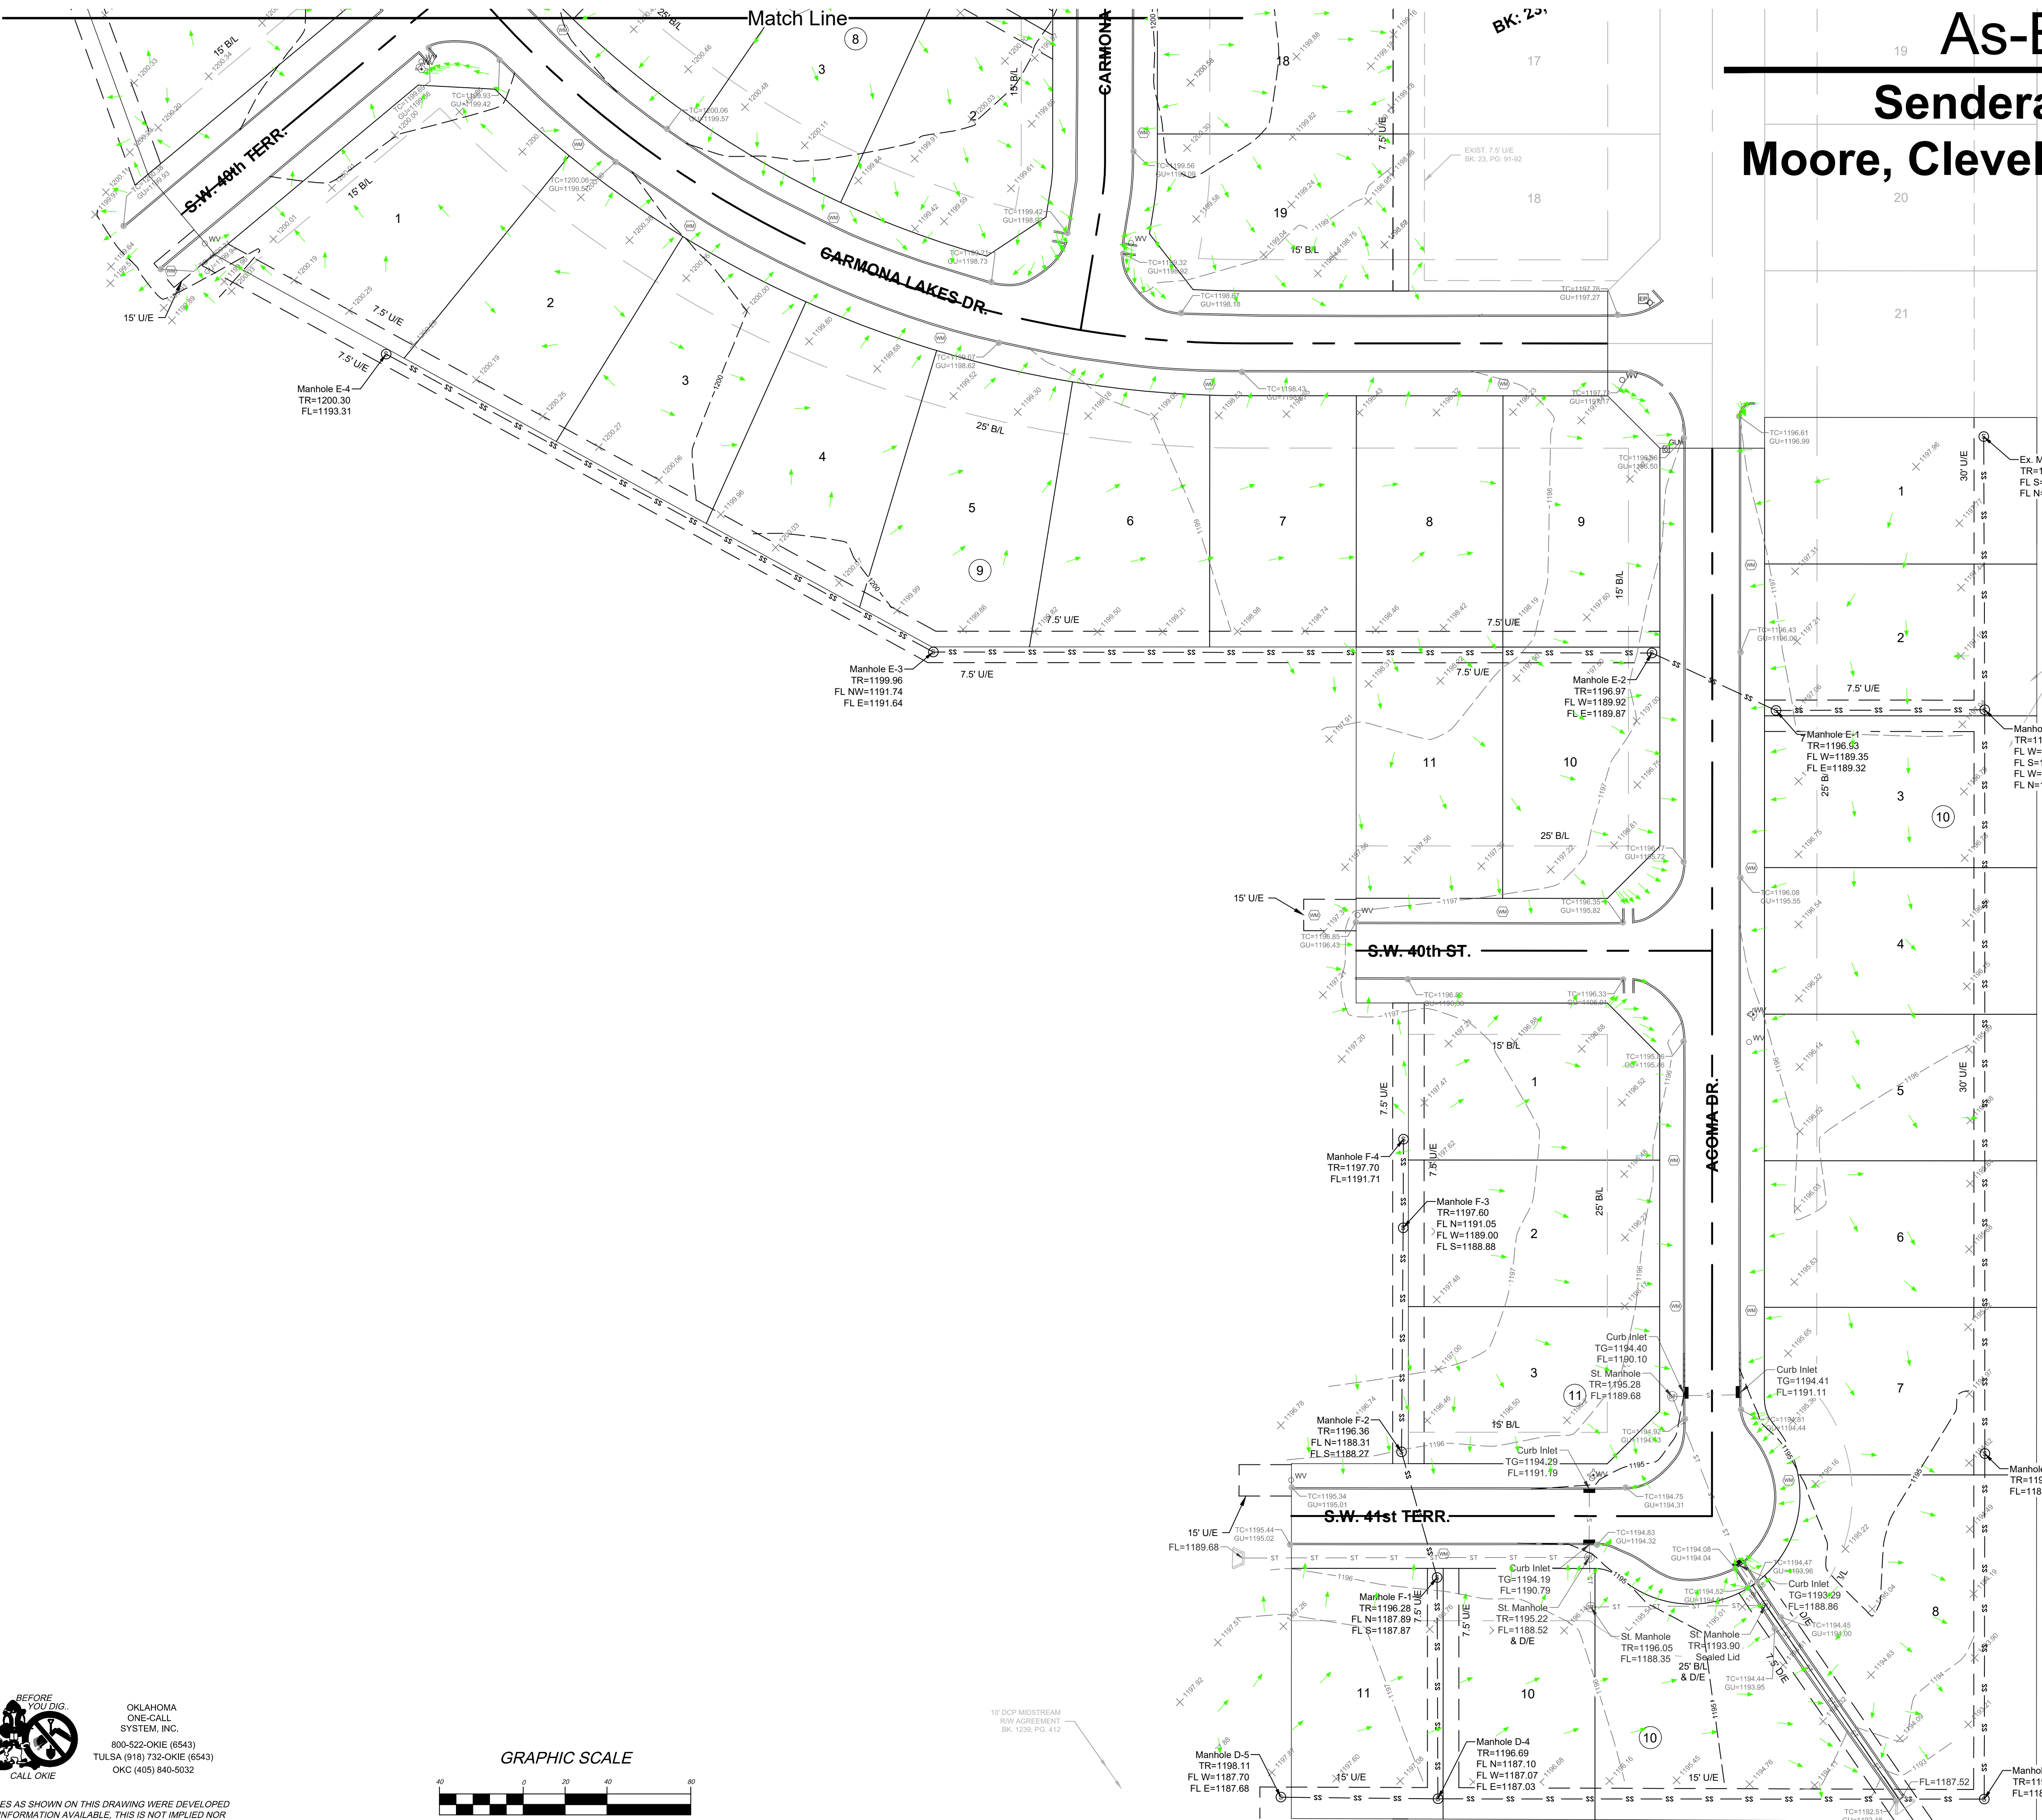

THE UTILITIES AS SHOWN ON THIS DRAWING WERE DEVELOPED FROM THE INFORMATION AVAILABLE. THIS IS NOT IMPLIED NOR INTENDED TO BE THE COMPLETE INVENTORY OF UTILITIES IN THIS AREA. IT IS THE CLIENT'S RESPONSIBILITY TO VERIFY THE LOCATION OF ALL UTILITIES (WHETHER SHOWN OR NOT) AND PROTECT SAID UTILITIES FROM ANY DAMAGE.

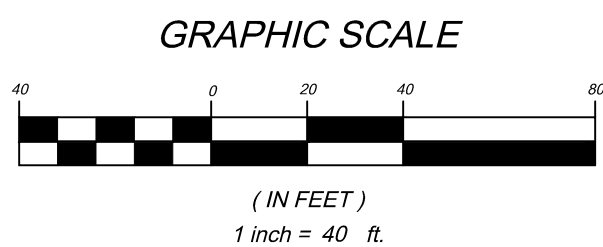


As-Built Survey

Sendera Lakes Section 2

Moore, Cleveland County, Oklahoma

NO.	REVISION/ISSUE	DATE

CLIENT
David Odom
2300 SW 89th Street, Suite A
Oklahoma City, Oklahoma 73159
(405) 794-6366

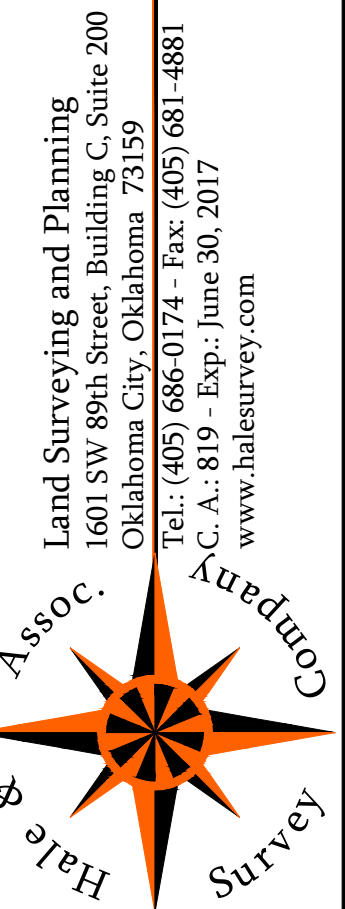

PROJECT NAME
Sendera Lakes Section 2
Moore, Oklahoma
As-Built Survey

PROJECT NO.	5374.4
FILE	5374-4 As-Built.dwg
DATE	6/7/2016
DRAWN BY	JMS
CHECKED BY	CLH
FIELD CREW	CH, JB